PROJECT

Minor Use Permit
Centrally Grown / DRC2012-00119

EXHIBIT

Vicinity Map

PROJECT

Minor Use Permit
Centrally Grown / DRC2012-00119

EXHIBIT

Land Use Category Map

PROJECT

Minor Use Permit
Centrally Grown / DRC2012-00119

EXHIBIT

Aerial

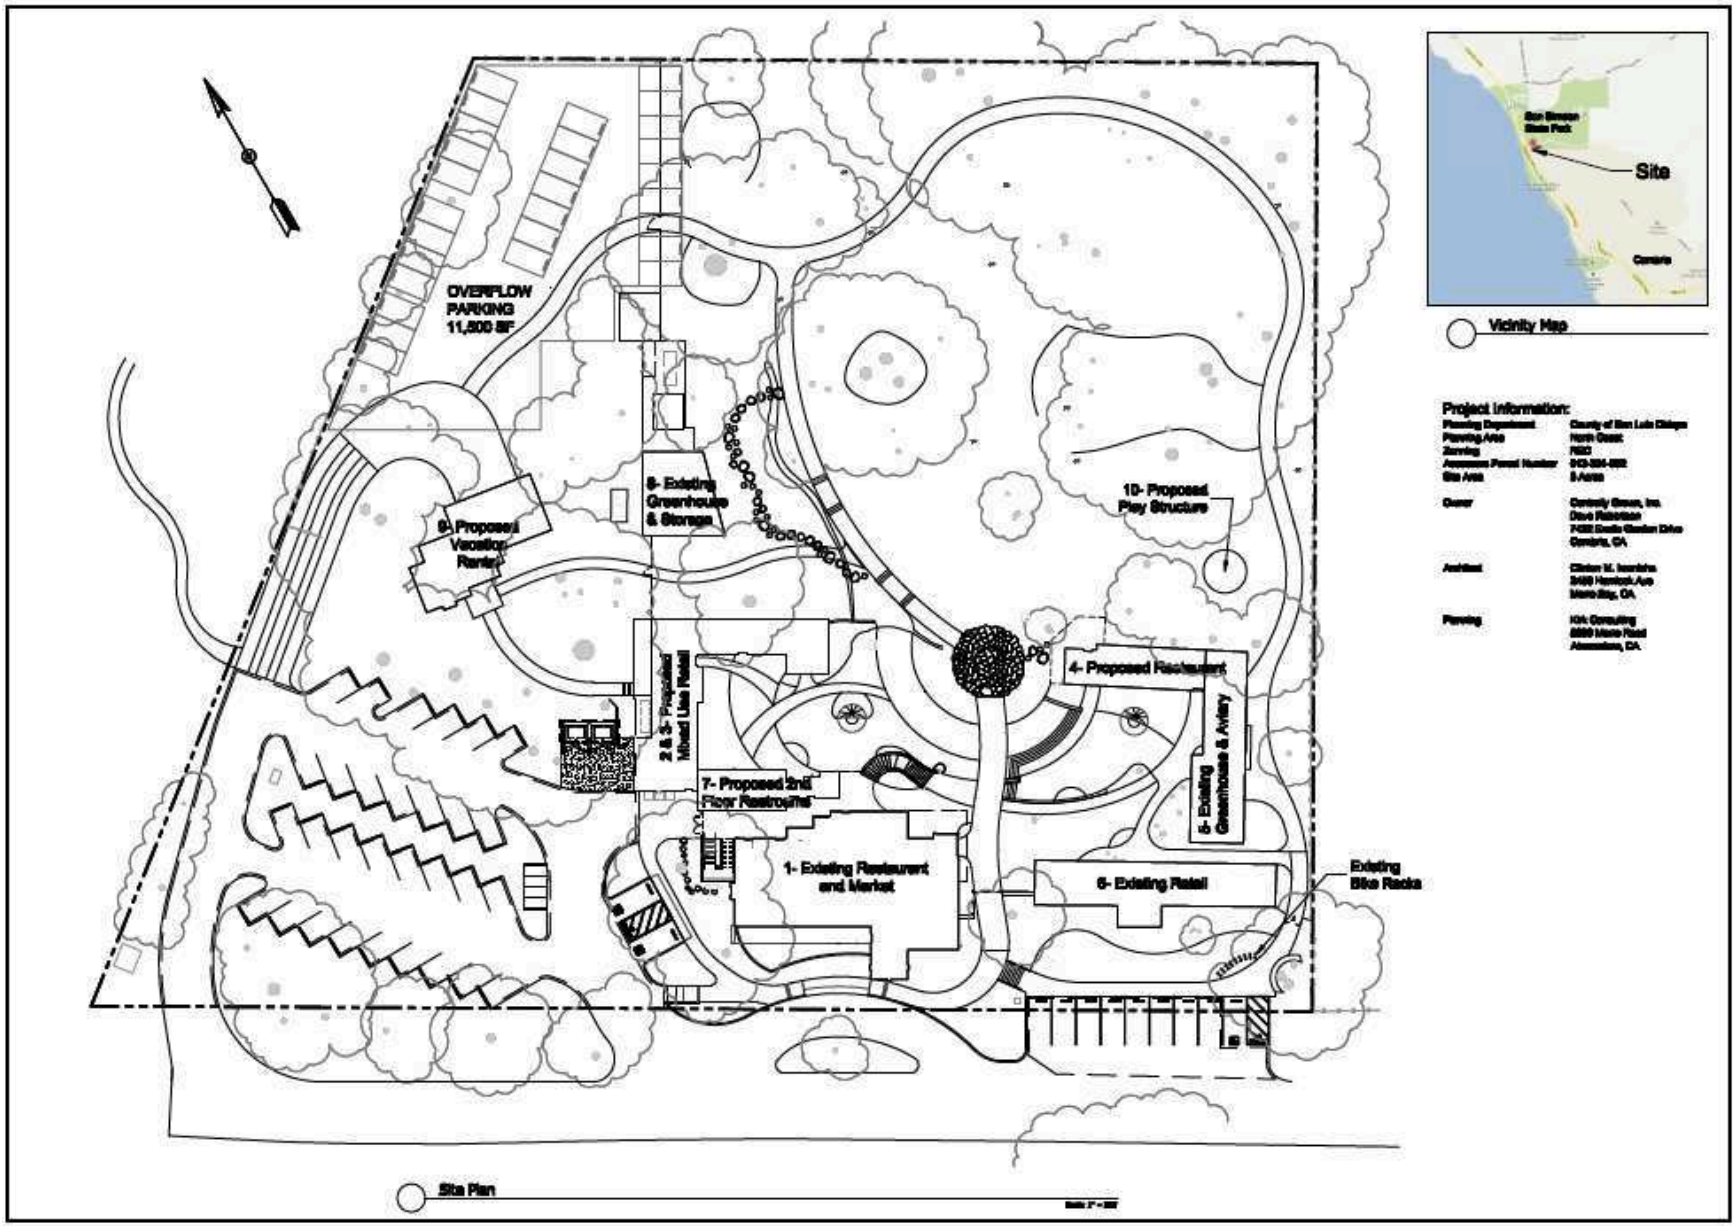

PROJECT

Minor Use Permit
Centrally Grown DRC2012-00119

EXHIBIT

Site Plan

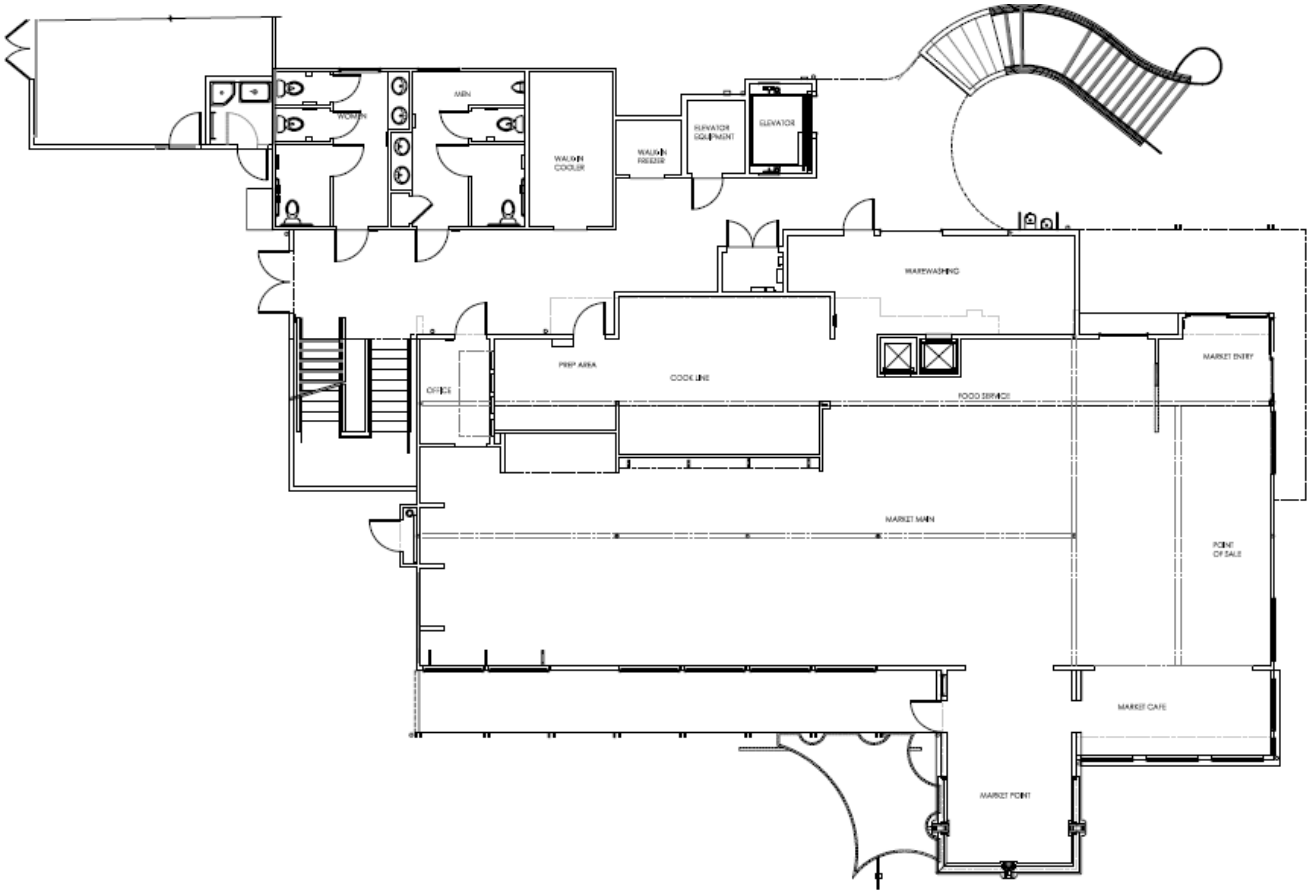

FIRST FLOOR PLAN (Existing- No Changes Proposed)
SCALE: 1/4" = 1'-0"

PROJECT

Minor Use Permit
Centrally Grown DRC2012-00119

EXHIBIT

Site Plan

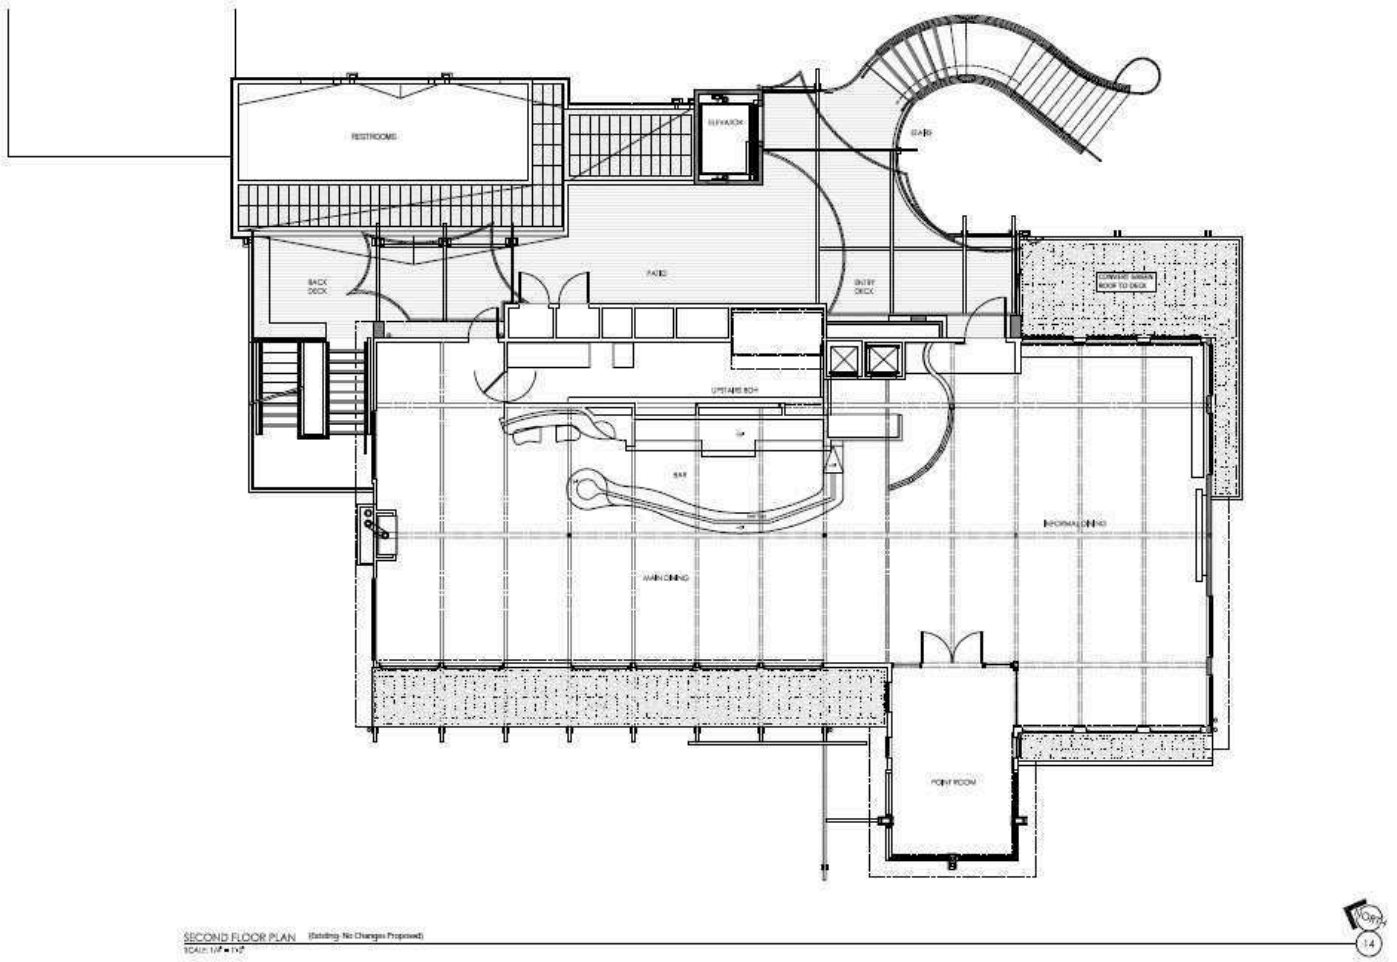

PROJECT

Minor Use Permit
Centrally Grown DRC2012-00119

EXHIBIT

Site Plan

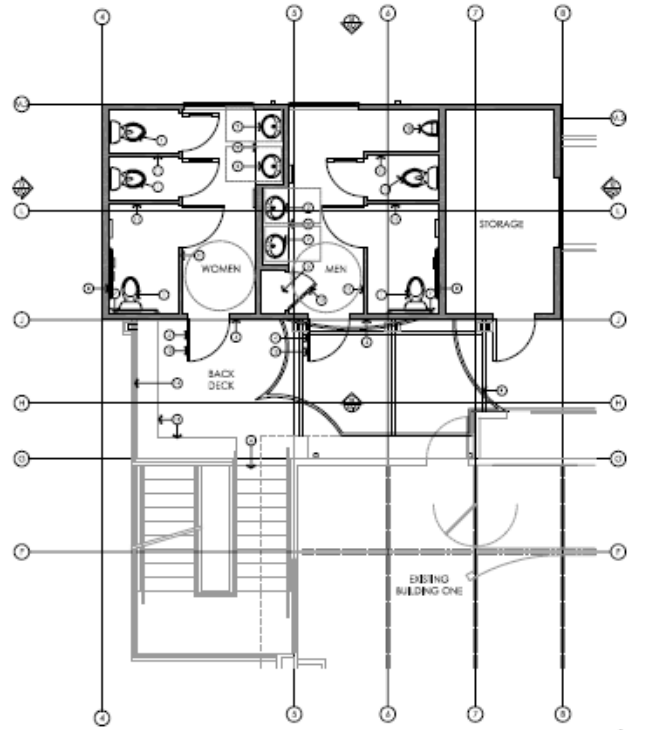

FUTURE SECOND FLOOR RESTROOM PLAN 14

SCALE: 1/4" = 1'-0"

LEGEND 25

FLOOR PLAN REFERENCE NOTES 15

PROJECT

Minor Use Permit
Centrally Grown DRC2012-00119

EXHIBIT

Site Plan

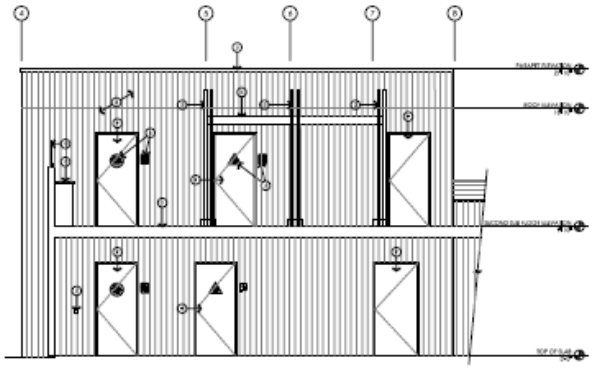

FUTURE SECOND FLOOR RESTROOM WEST ELEVATION 32

SCALE: 1/4"=1'-0"

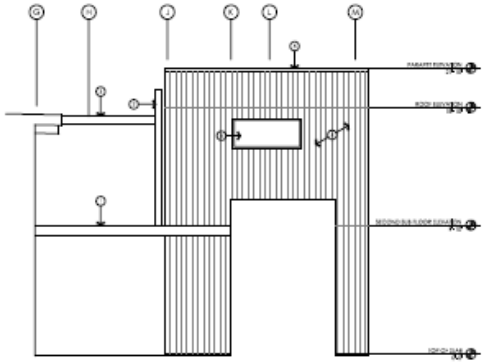

FUTURE SECOND FLOOR RESTROOM SOUTH ELEVATION 12

SCALE: 1/4"=1'-0"

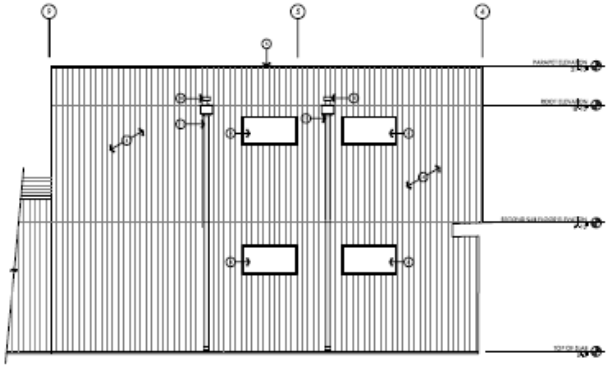

FUTURE SECOND FLOOR RESTROOM EAST ELEVATION 33

SCALE: 1/4"=1'-0"

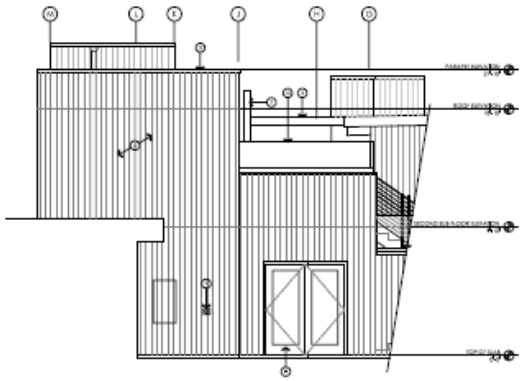

FUTURE SECOND FLOOR RESTROOM NORTH ELEVATION 13

SCALE: 1/4"=1'-0"

LEGEND 24

ELEVATION REFERENCE NOTES 14

PROJECT

Minor Use Permit
Centrally Grown DRC2012-00119

EXHIBIT

Site Plan

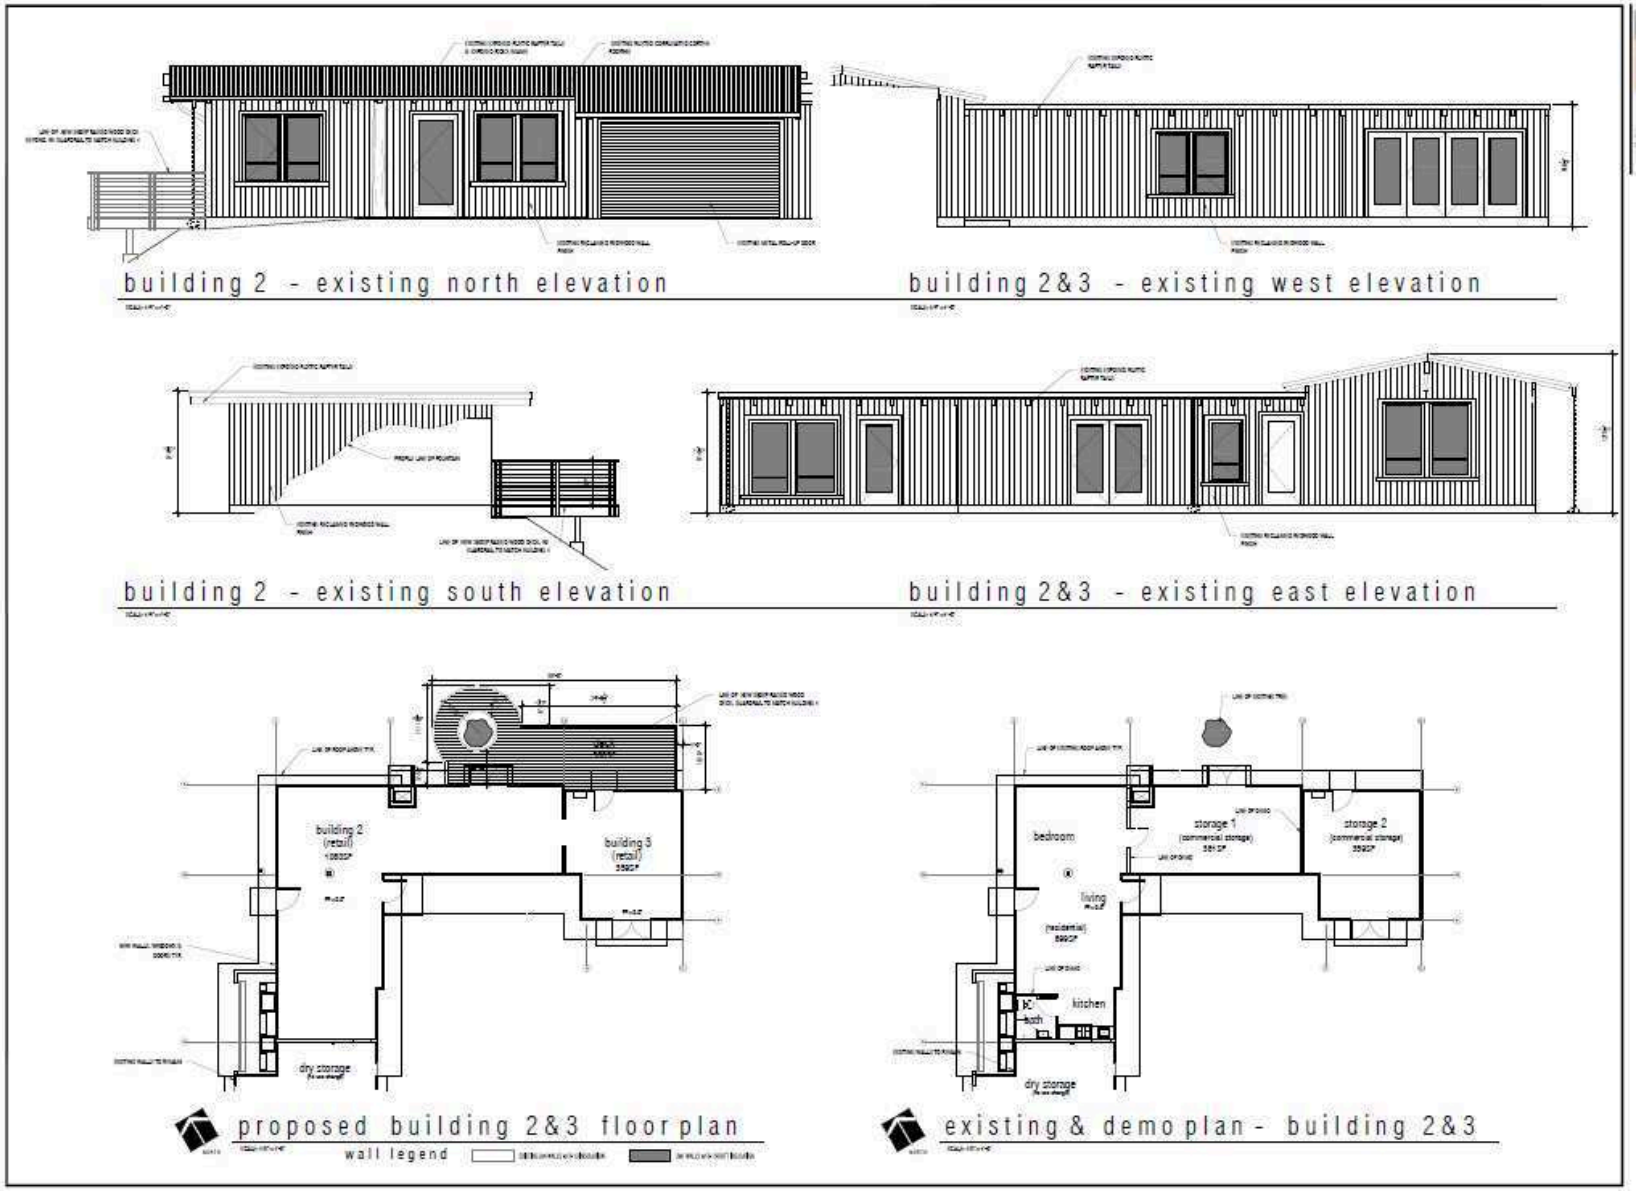

PROJECT

Minor Use Permit
Centrally Grown DRC2012-00119

EXHIBIT

Site Plan

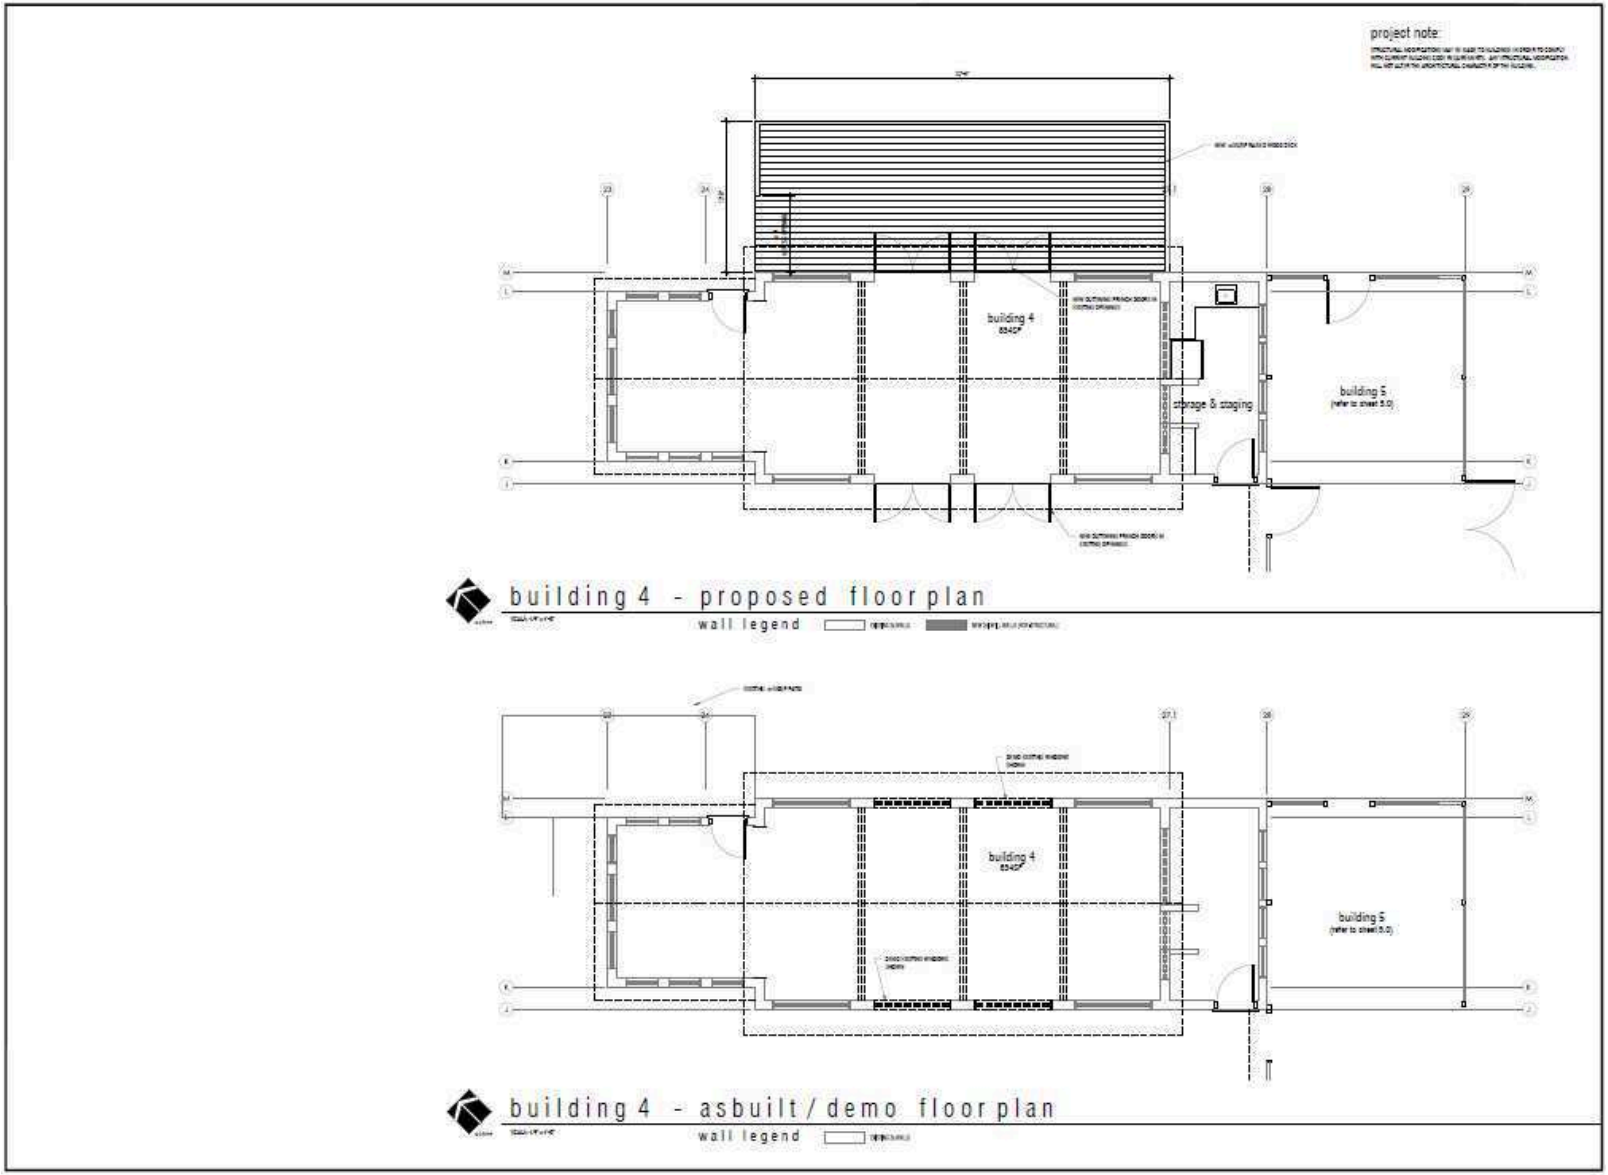

PROJECT

Minor Use Permit
Centrally Grown DRC2012-00119

EXHIBIT

Site Plan

building 4 - proposed remodeled west view (east similar)

project note:

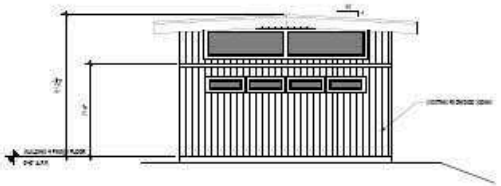

building 4 - existing south view

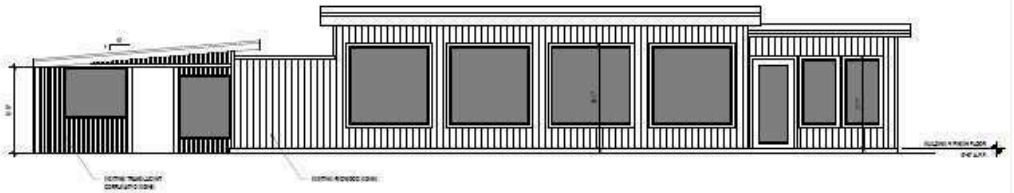

building 4 - existing east view

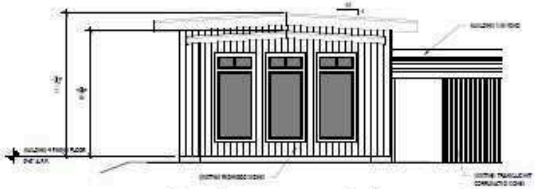

building 4 - existing north view

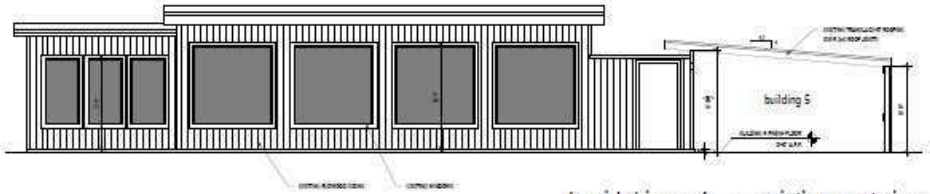

building 4 - existing west view

PROJECT

Minor Use Permit
Centrally Grown DRC2012-00119

EXHIBIT

Site Plan

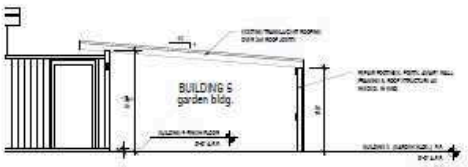

2 typical garden building section

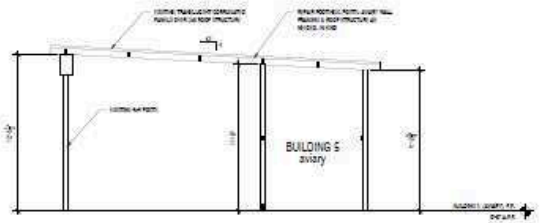

1 typical aviary building section

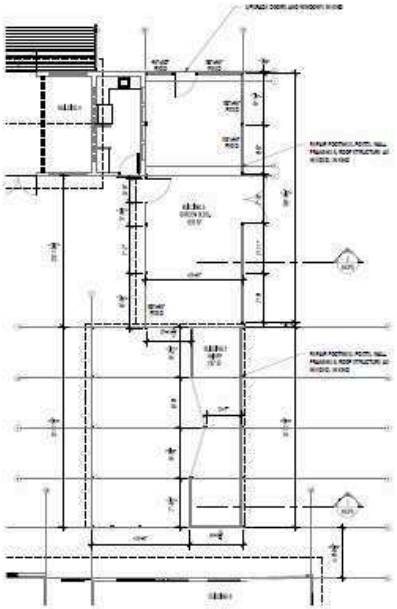

project note:

building 5 - proposed floor plan

wall legend

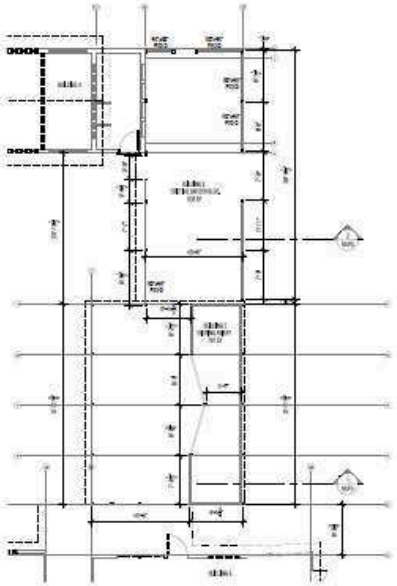

building 5 - asbuilt / demo floor plan

wall legend

PROJECT

Minor Use Permit
Centrally Grown DRC2012-00119

EXHIBIT

Site Plan

project note:

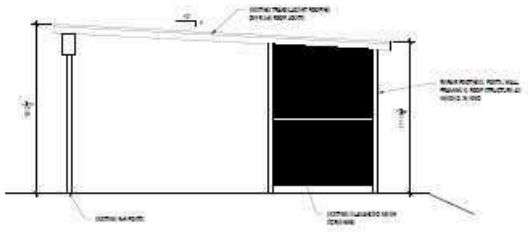

building 5 aviary - existing west view (east similar)

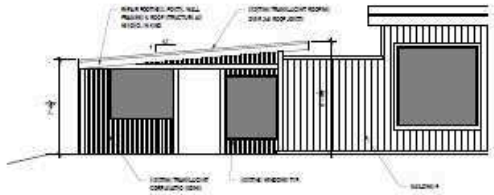

building 5 garden building - existing east view

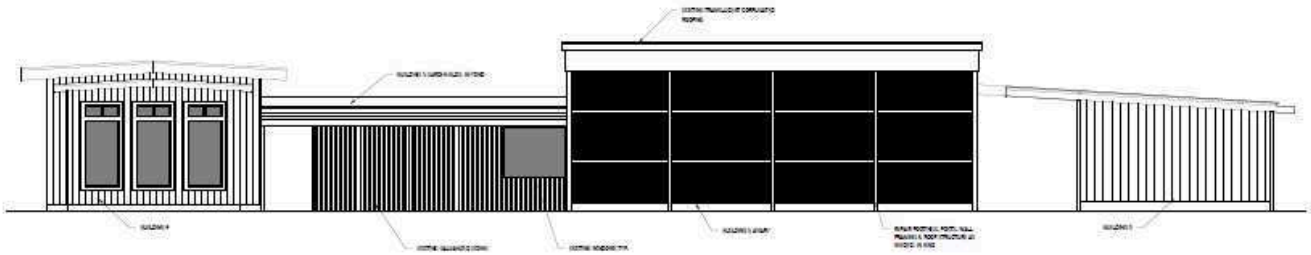

buildings 4, 5 & 6 - existing north view

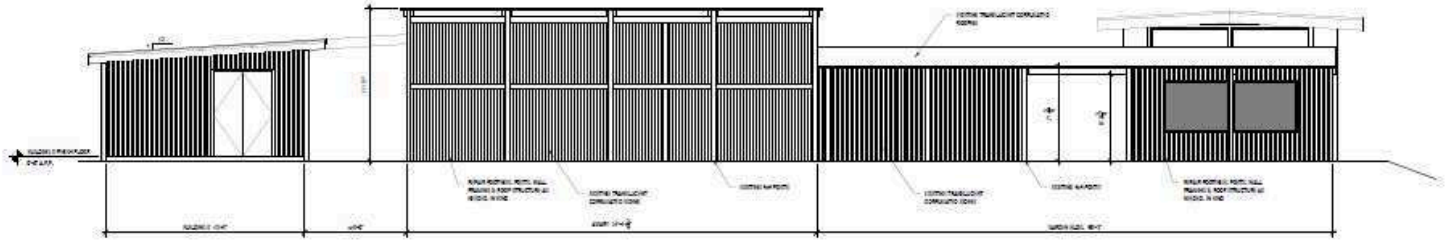

building 5 & 6 - existing south view

PROJECT

Minor Use Permit
Centrally Grown DRC2012-00119

EXHIBIT

Site Plan

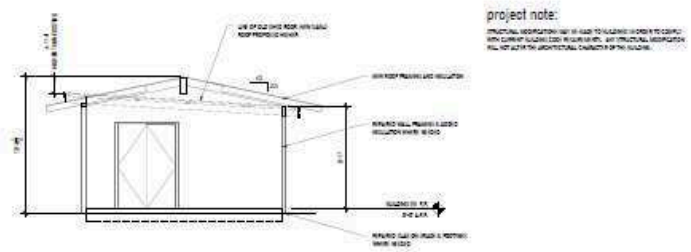

1 typical repaired building section

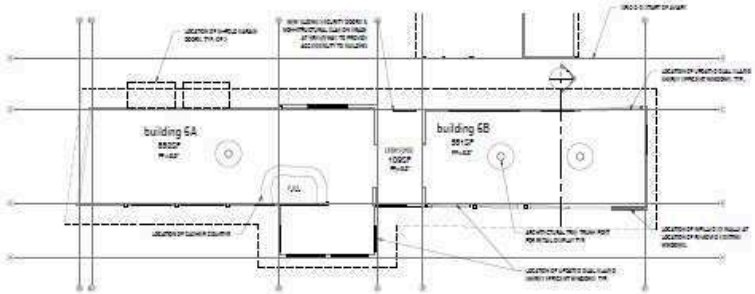

building 6 - remodeled floor plan

wall legend

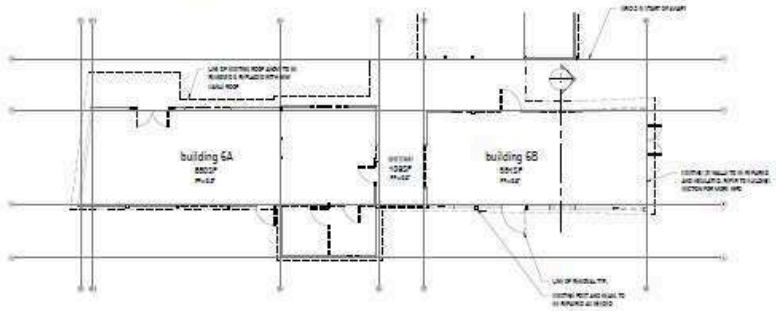

building 6 - asbuilt / demo floor plan

wall legend

PROJECT

Minor Use Permit
Centrally Grown DRC2012-00119

EXHIBIT

Site Plan

project note:

building 6 - proposed conceptual west rendering

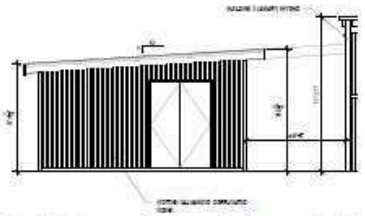

building 6 - existing south view

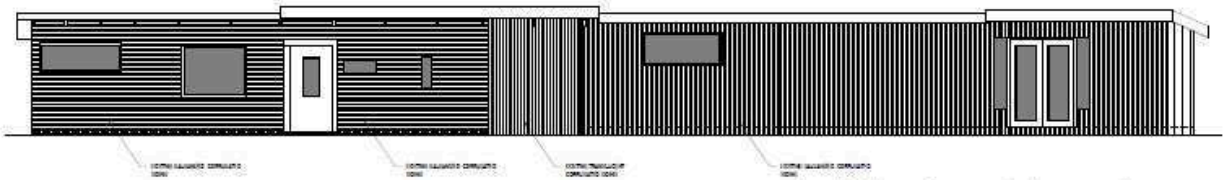

building 6 - existing east view

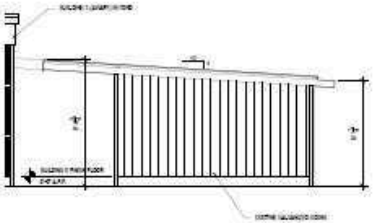

building 6 - existing north view

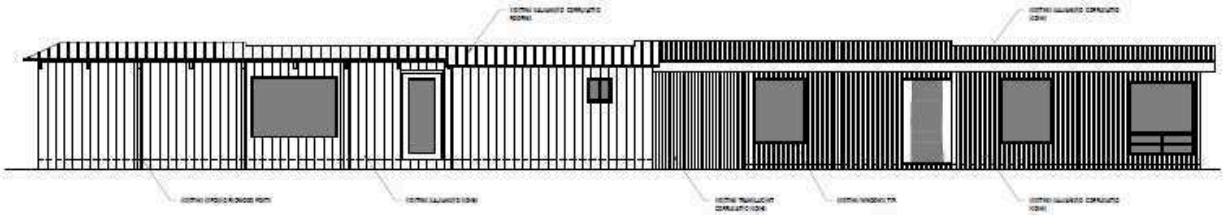

building 6 - existing west view

PROJECT

Minor Use Permit
Centrally Grown DRC2012-00119

EXHIBIT

Site Plan

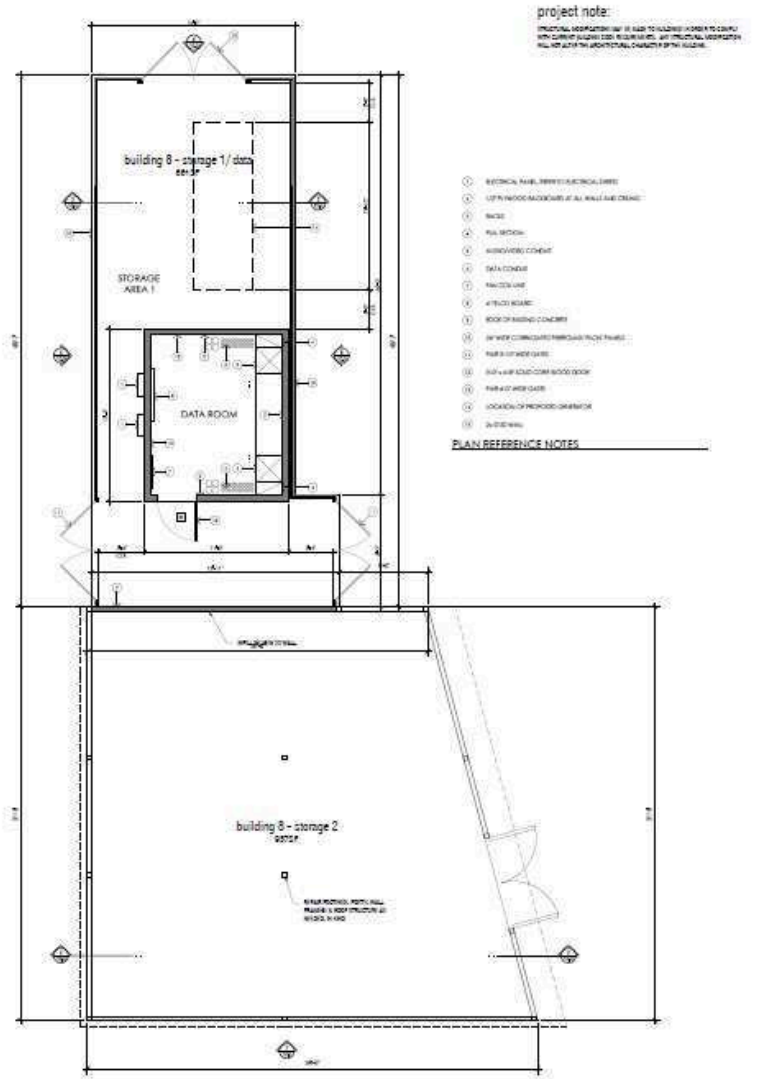

PROJECT

Minor Use Permit
Centrally Grown DRC2012-00119

EXHIBIT

Site Plan

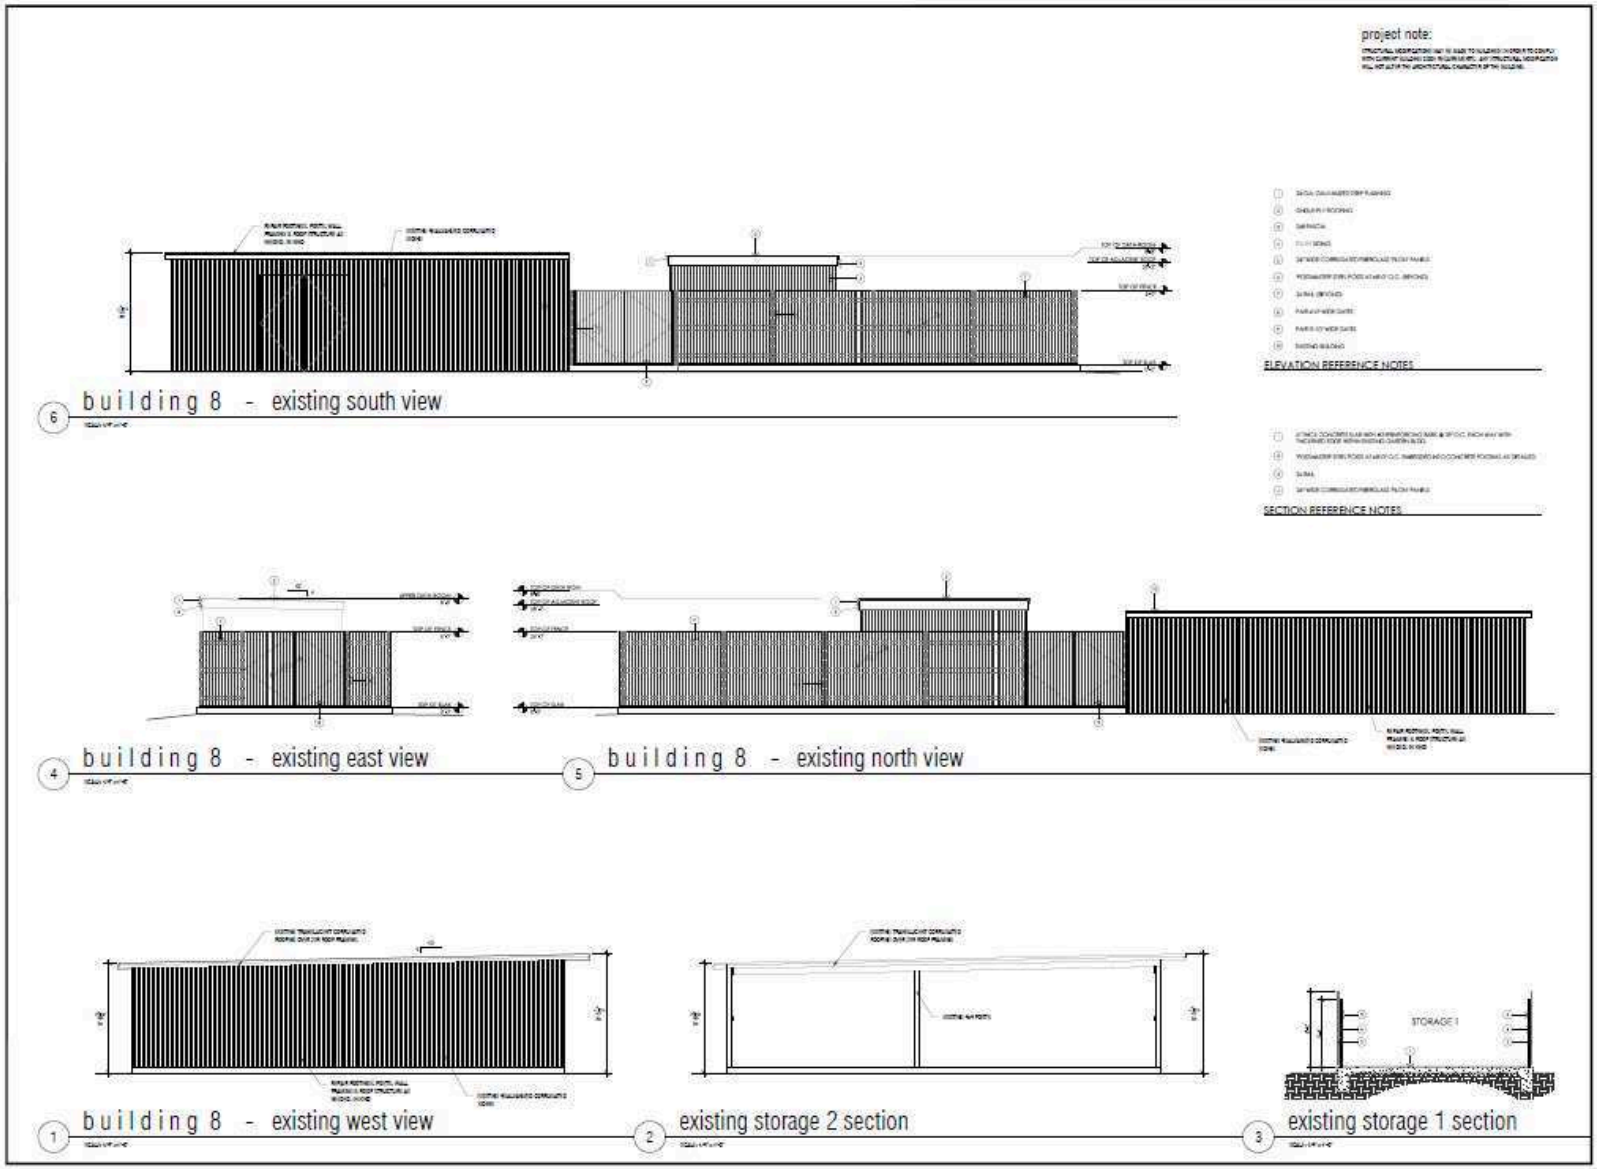

PROJECT

Minor Use Permit
Centrally Grown DRC2012-00119

EXHIBIT

Site Plan

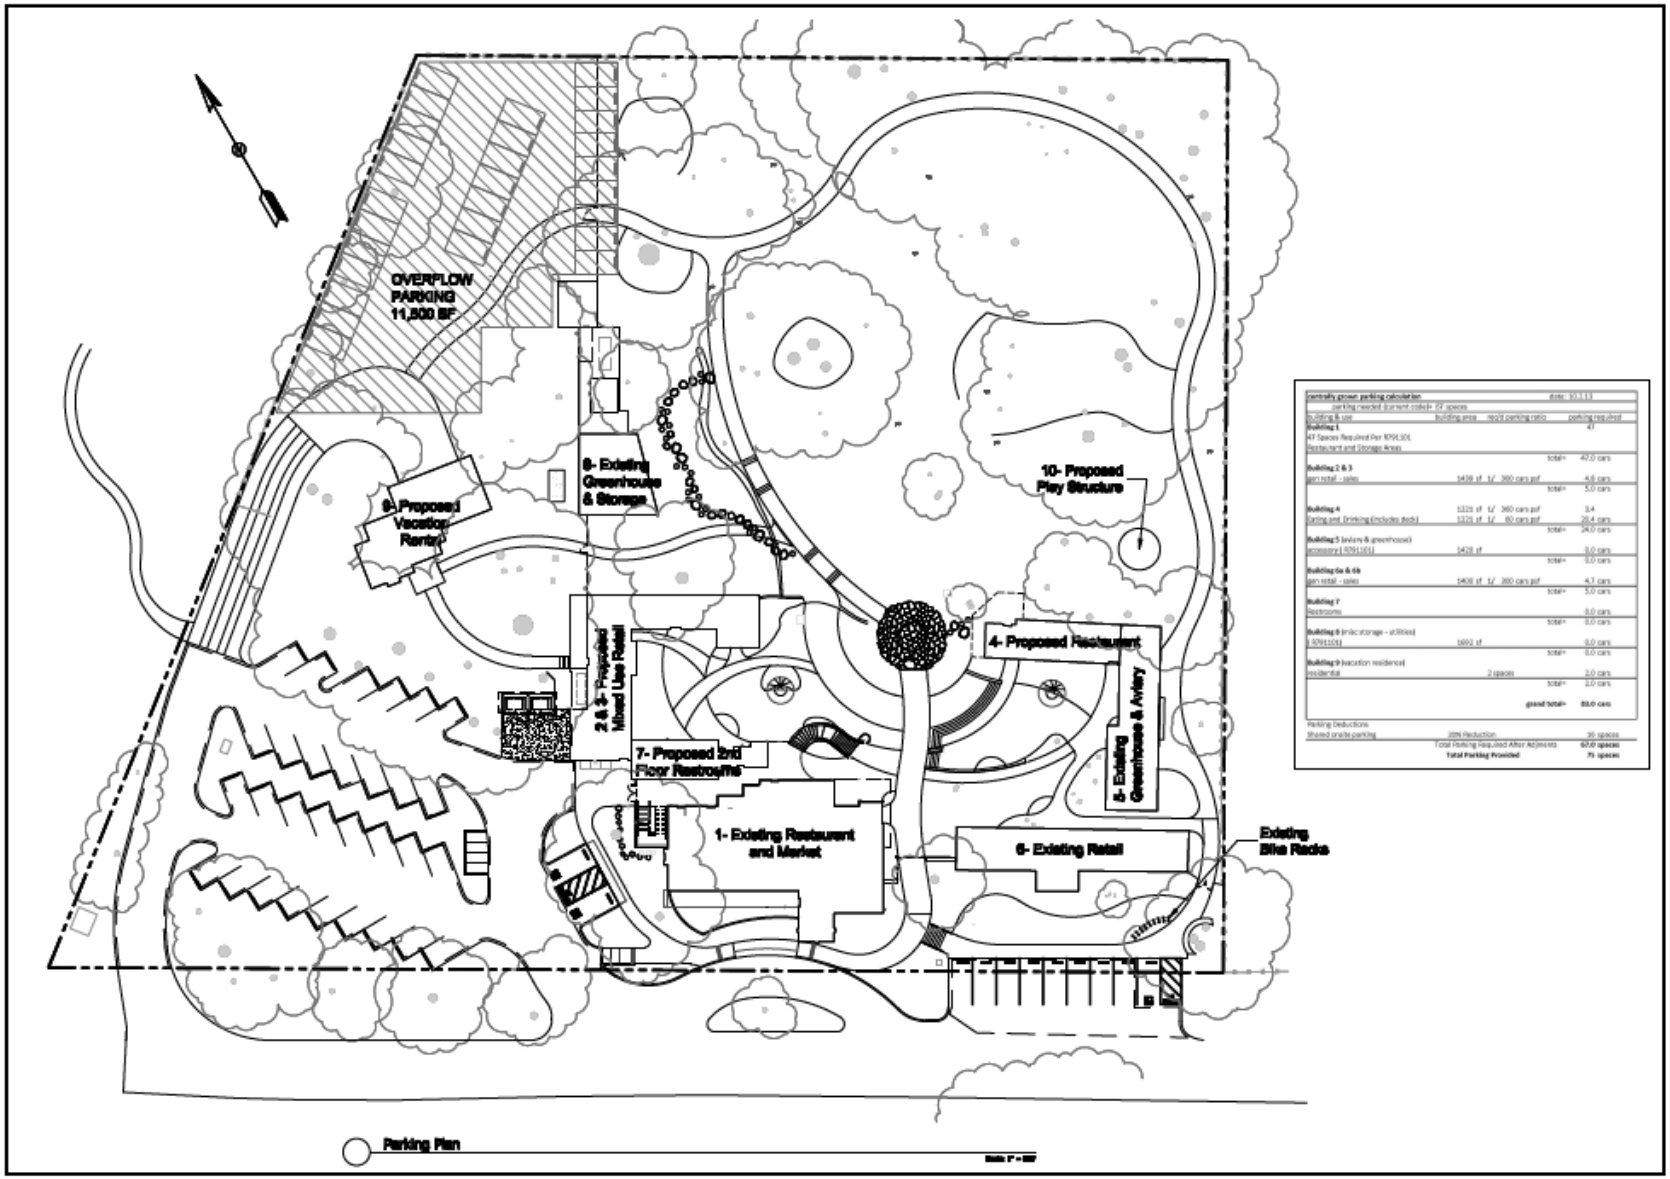

PROJECT

Minor Use Permit
Centrally Grown DRC2012-00119

EXHIBIT

Site Plan